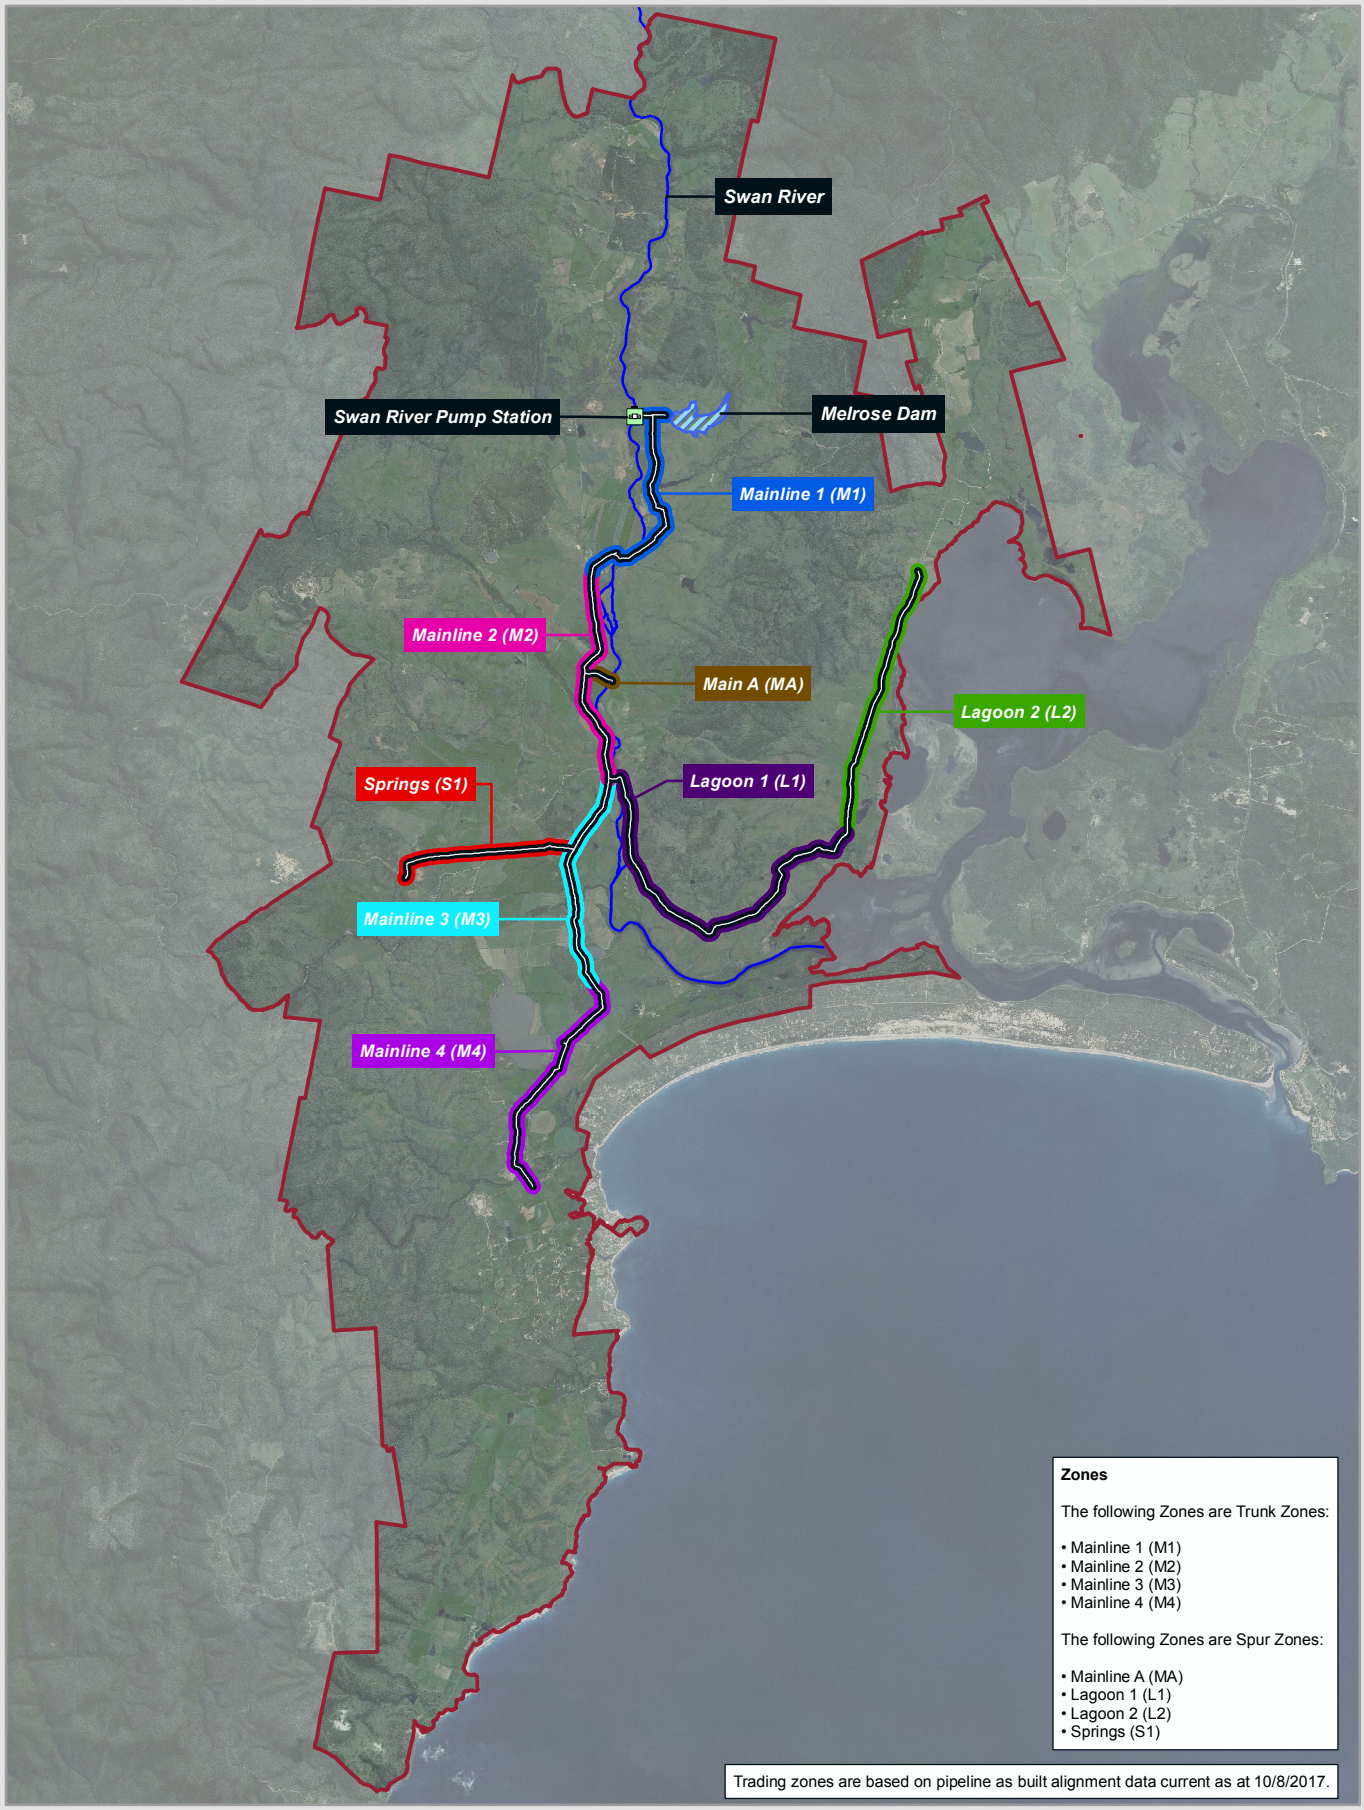

Zones

The following Zones are Trunk Zones:

- Mainline 1 (M1)
- Mainline 2 (M2)
- Mainline 3 (M3)
- Mainline 4 (M4)

The following Zones are Spur Zones:

- Mainline A (MA)
- Lagoon 1 (L1)
- Lagoon 2 (L2)
- Springs (S1)

Trading zones are based on pipeline as built alignment data current as at 10/8/2017.

Legend

- Pump Station
- As Built Pipeline
- Melrose Dam Maximum Flood Level
- Proposed Irrigation District

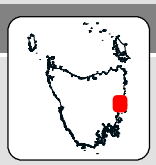

SWAN Trading Zones

0 2 4
Kilometres

Map Scale 1:150,000
When printed at A4

Map No: SWAN-M1423-001
Version: 001
Date: 29/8/2017
Map Updated by: MMcG (EMG)
Tasmanian Irrigation

Tasmanian Irrigation

Basemap supplied by TASMAP © State of Tasmania. Base data from the LIST © State of Tasmania.

DISCLAIMER: This map is for informational purposes only. It should not be relied upon to establish with certainty the location of any of the features represented on it, either absolutely or in relation to other features.This map is not suitable for site specific decision making.